



State of Utah  
DEPARTMENT OF NATURAL RESOURCES  
DIVISION OF STATE LANDS AND FORESTRY

Michael O. Leavitt  
Governor

Ted Stewart  
Executive Director

Scott Hirschi  
Division Director

3 Triad Center, Suite 400  
355 West North Temple  
Salt Lake City, Utah 84180-1204  
801-538-5508  
801-355-0922 (Fax)

5/037/081  
HOLIDAY CONSTRUCTION  
LIMESTONE QUARRY

February 23, 1994

Francis J. Nielson  
310 South Main  
Suite 1305  
Salt Lake City, UT 84101

Dear Mr. Nielson,

RE: Assignment of ML 45960-BSLS

Thank you for your FAX of February 18th in which you copied me your assignment of ML 45960. I have searched the division's records but find no trace of any previous submittal of this assignment. The assignment apparently was never approved by the director and you are still listed as the lessee of record.

The assignment which you submitted is not acceptable for processing because it does not specifically reference by lease number or legal description the lands being assigned. I am enclosing herewith the division's mineral lease assignment form. If you still desire a change in title of this mineral lease then please fill out and submit the enclosed form, in duplicate.


Currently, the administrative fee for a mineral lease assignment is \$25, but effective March 1, 1994, the fee will be changed to \$30. Proof of prior payment of the fee may be submitted along with your application.

If you do not desire to assign the lease then please provide me with a letter designating persons authorized to operate upon your leasehold.

Sincerely,

JOHN T. BLAKE  
MINERAL RESOURCES SPECIALIST

JTB/tdw  
Enclosure

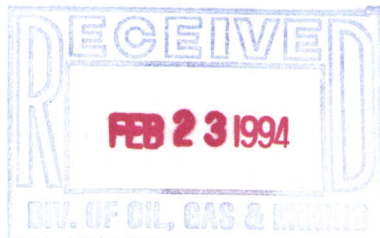





SW 1/4 SW 1/4

1" = 250'  
S/037/081  
REVISED SKETCH BY DOGM  
DRAWN TO SCALE

5918

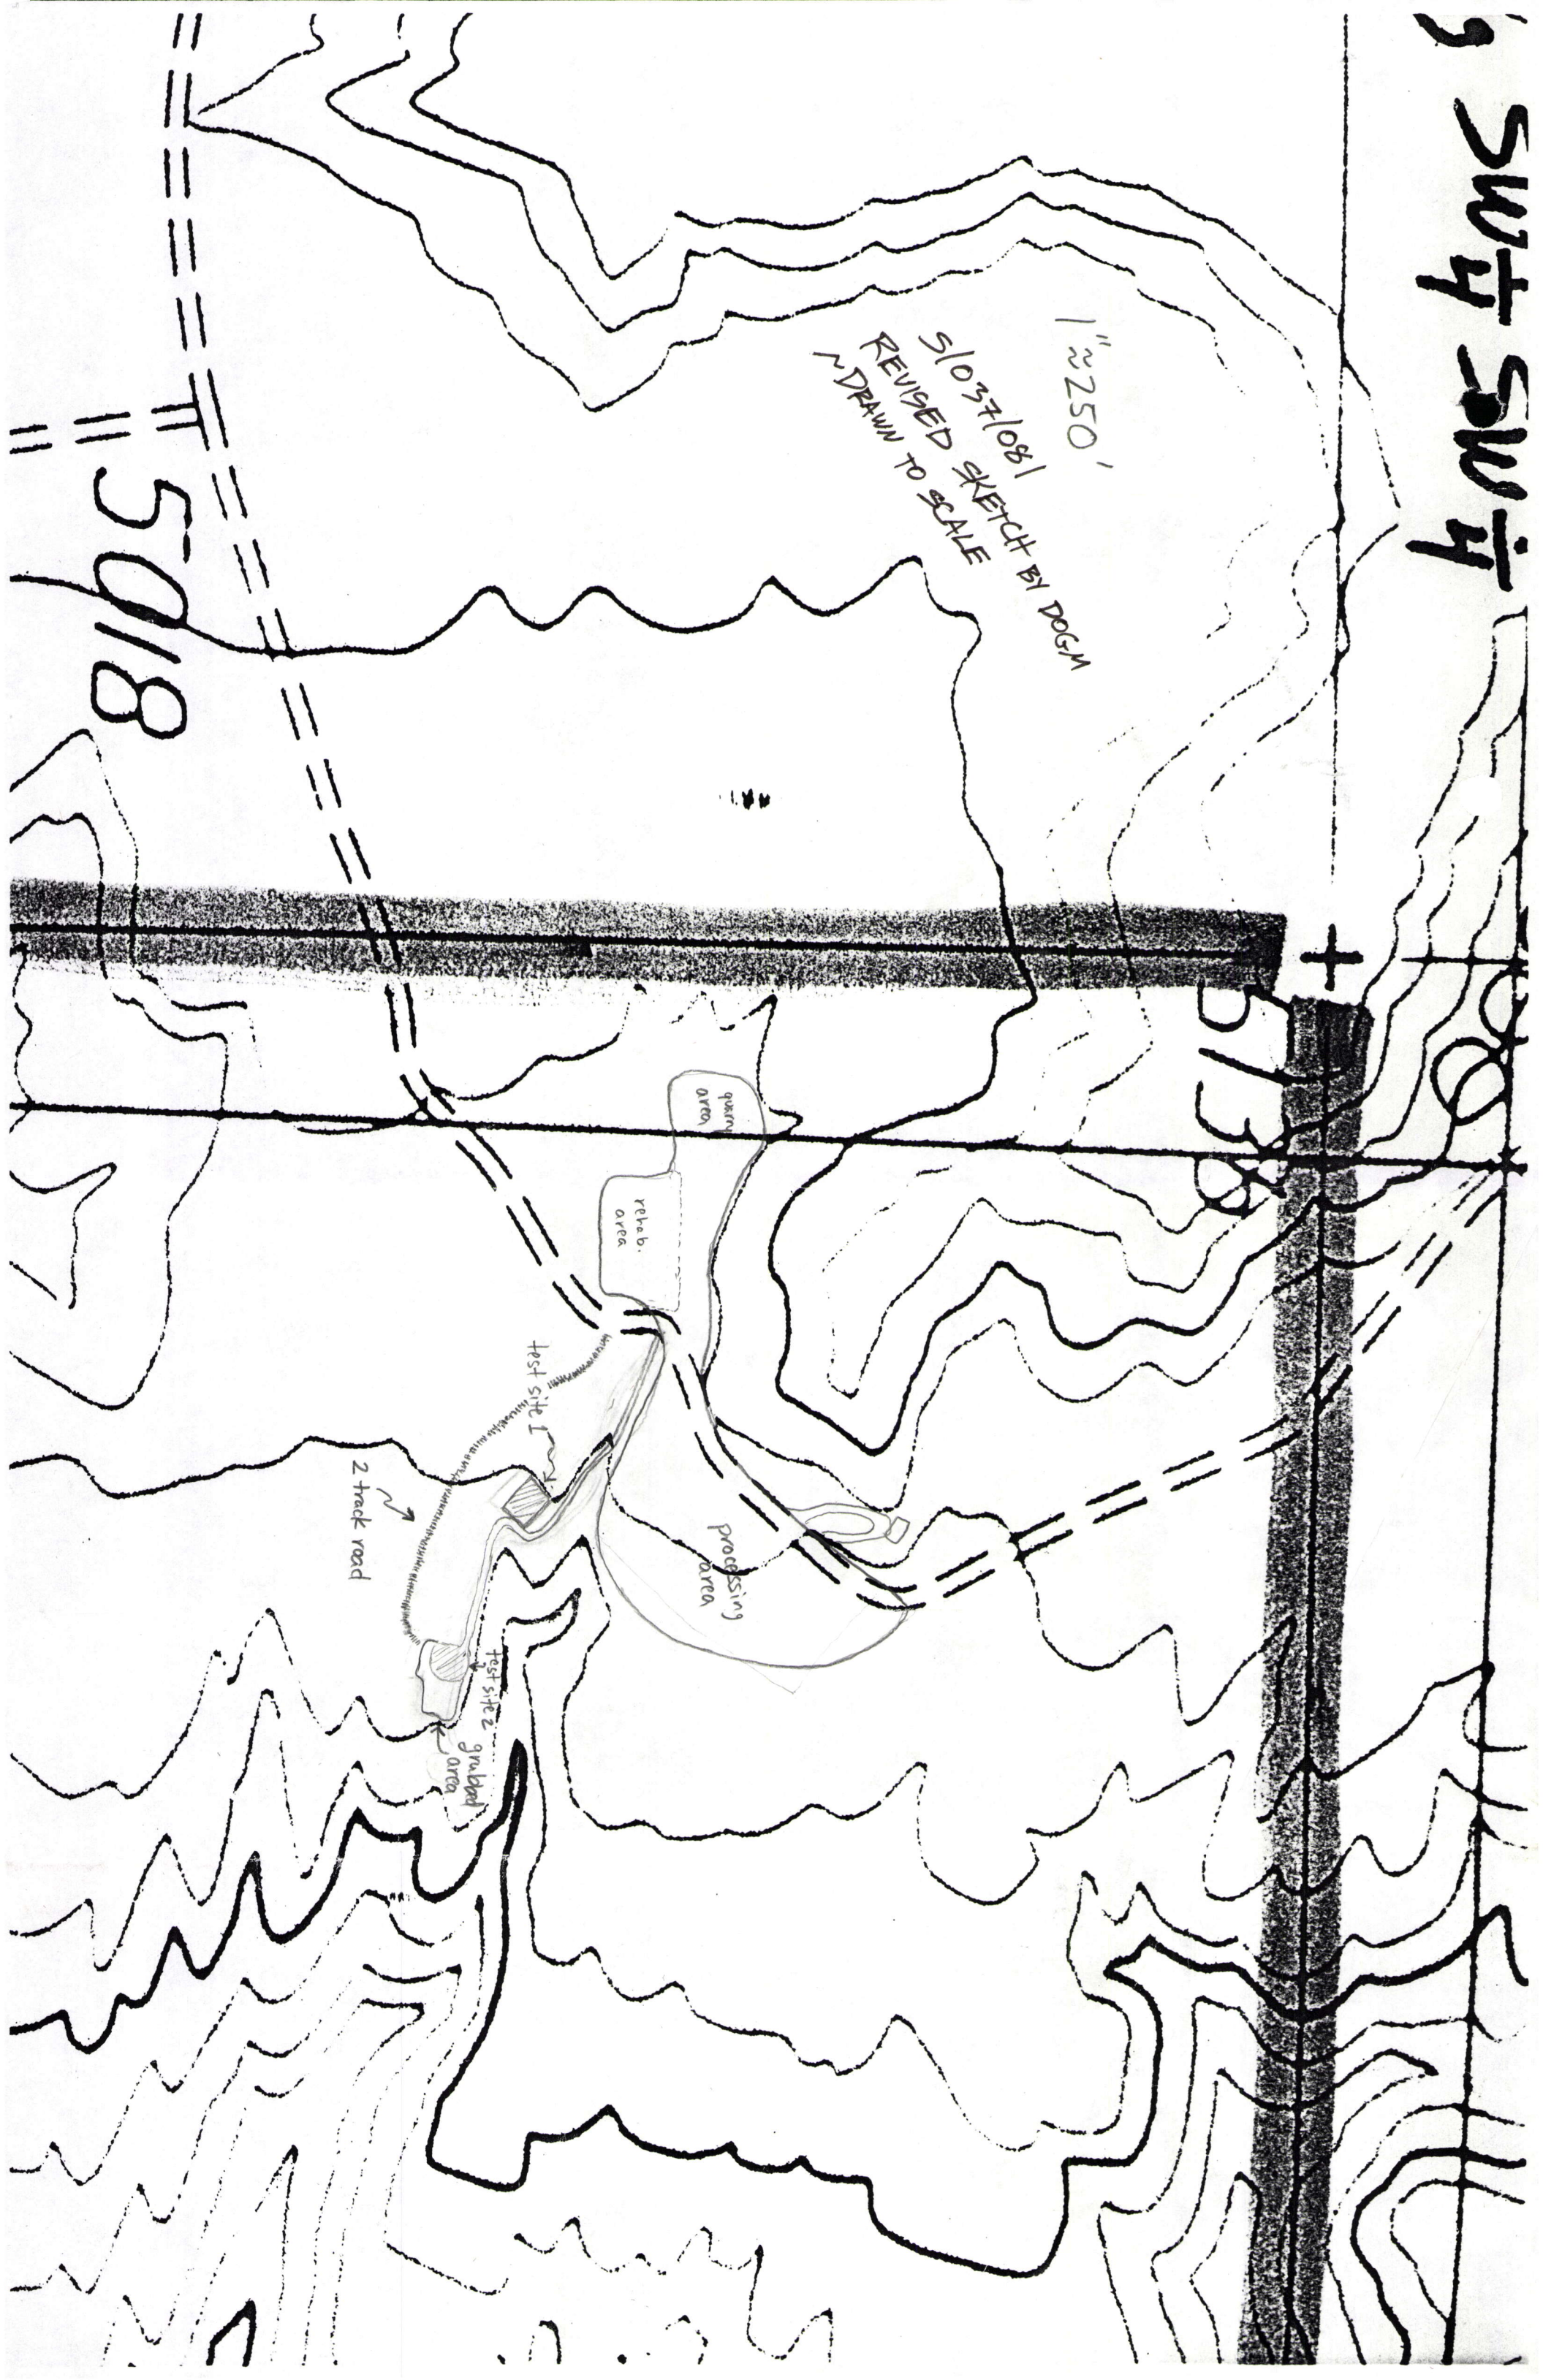



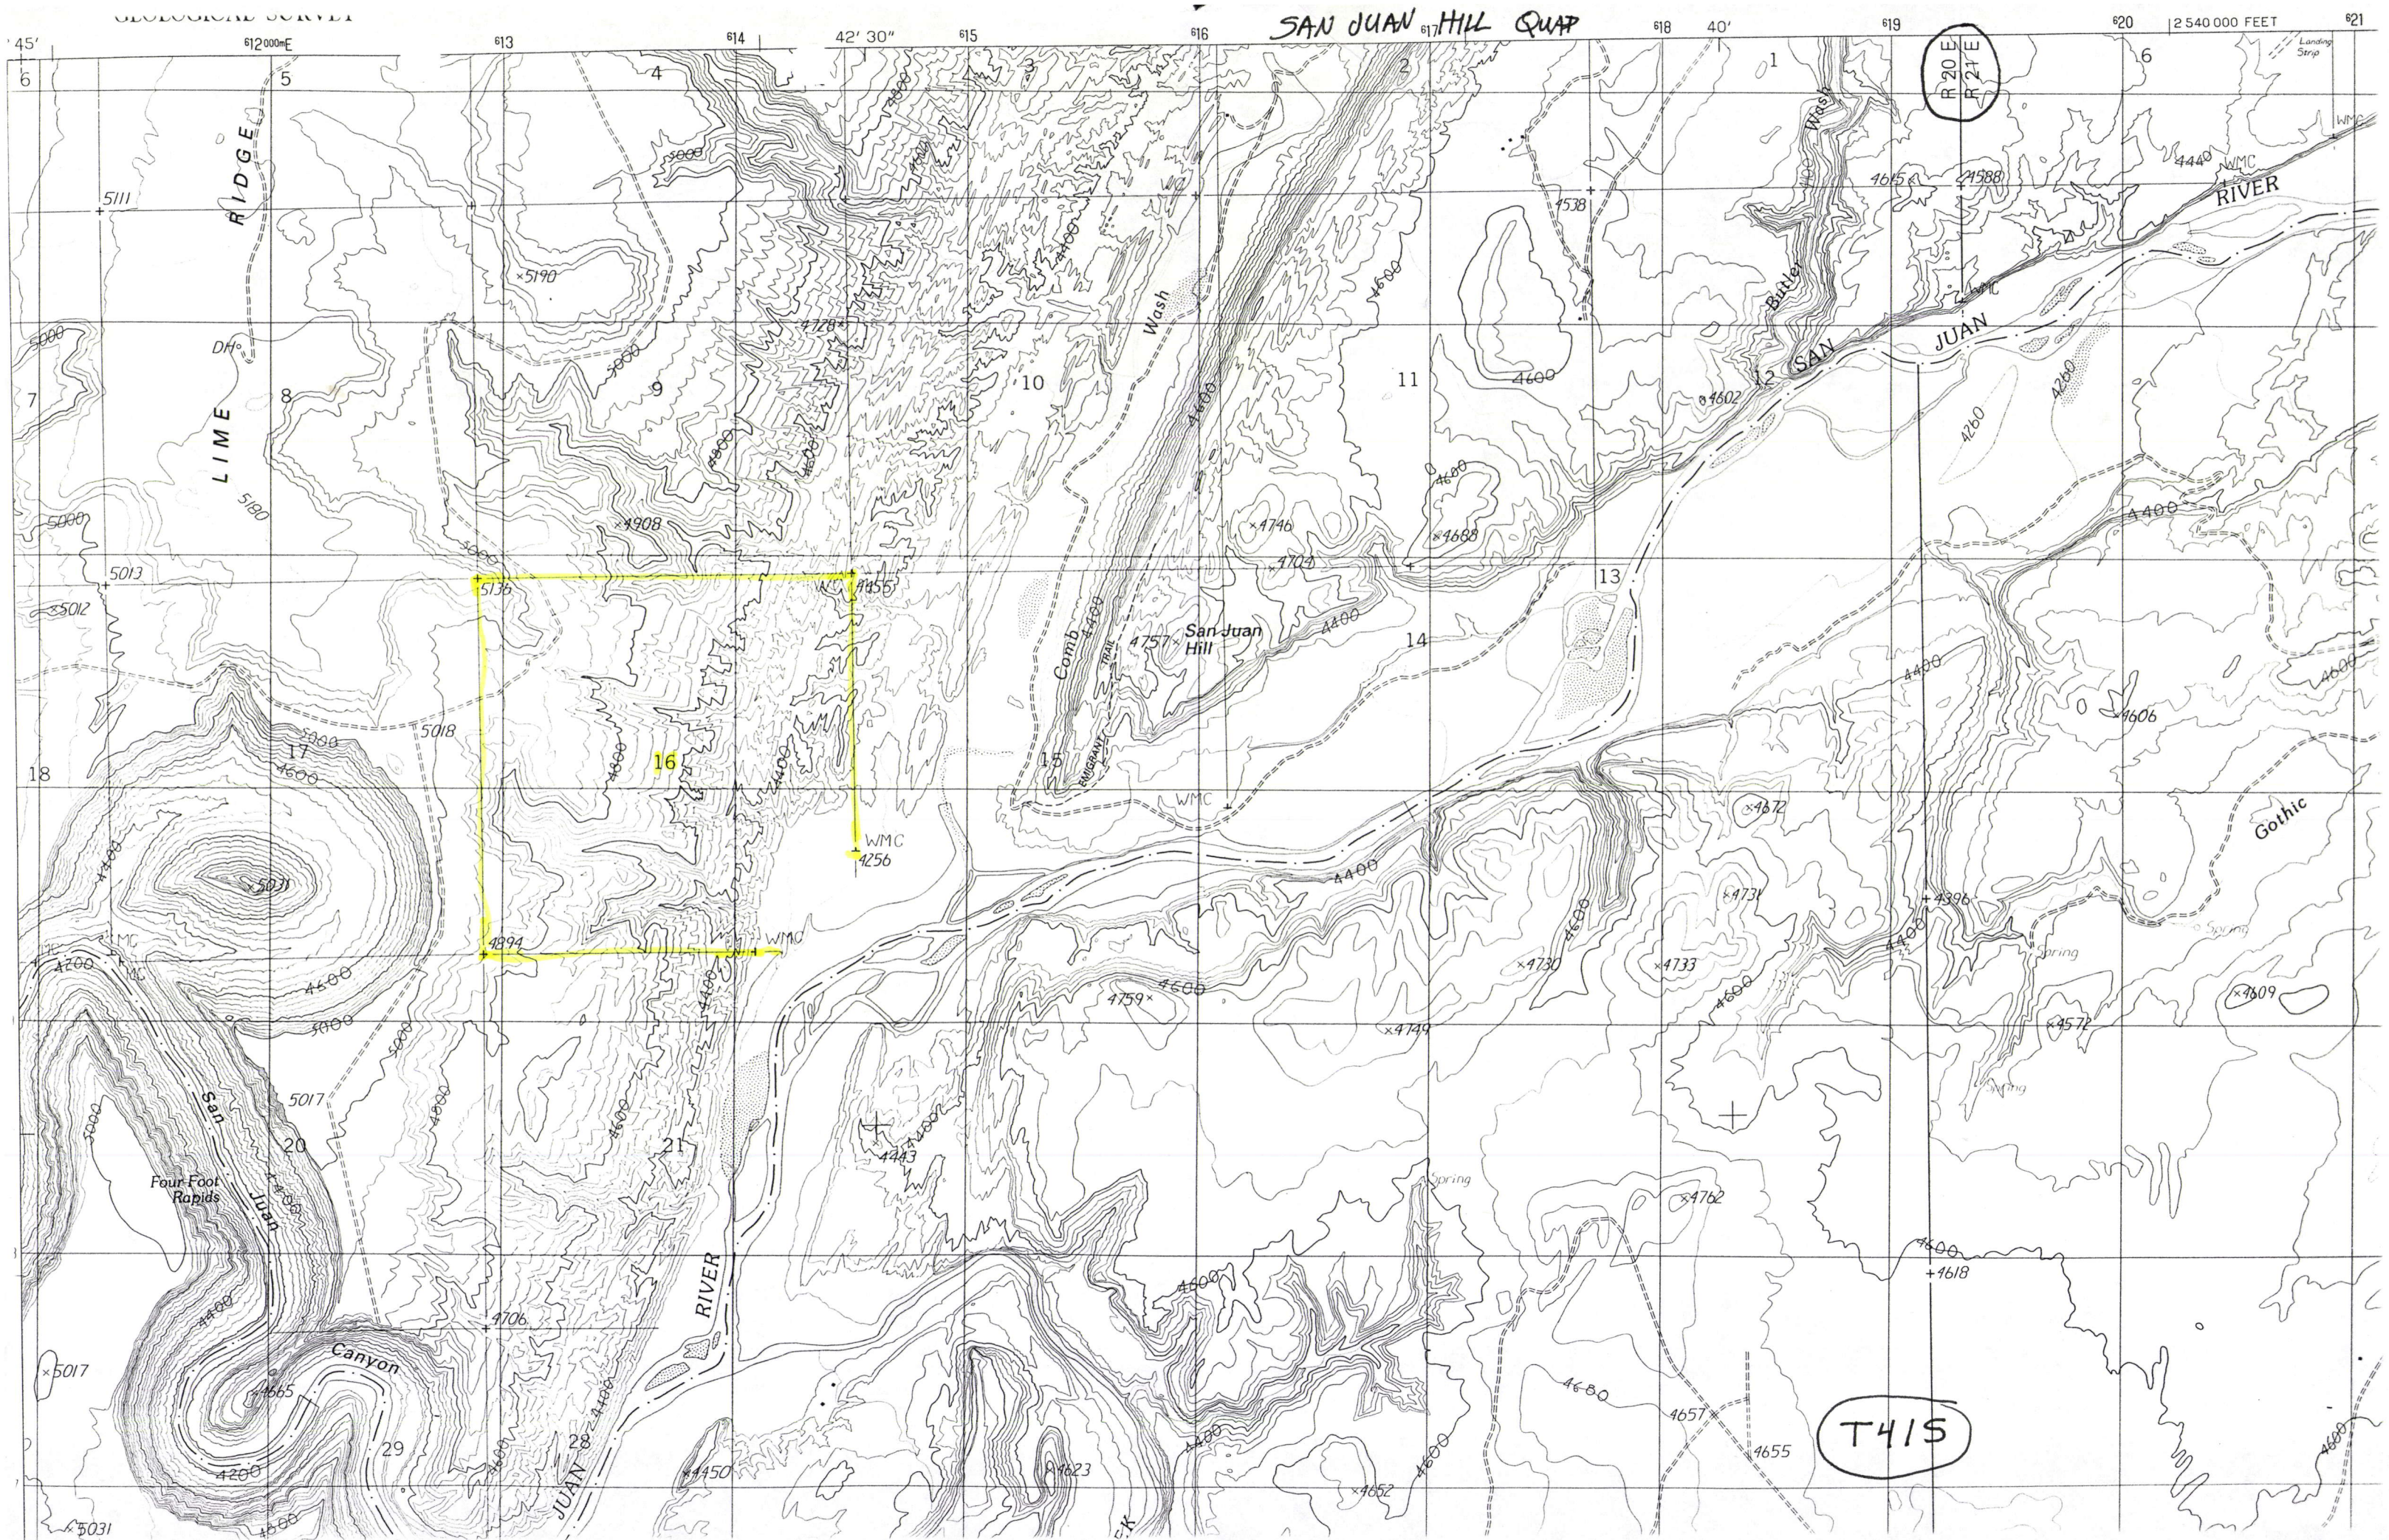




AN JUAN HILL QUAD  
200%

ML 45960 (440 ACRES)

N $\frac{1}{2}$ , N $\frac{1}{2}$ SW $\frac{1}{4}$ , SW $\frac{1}{4}$ SW $\frac{1}{4}$

5/037/081

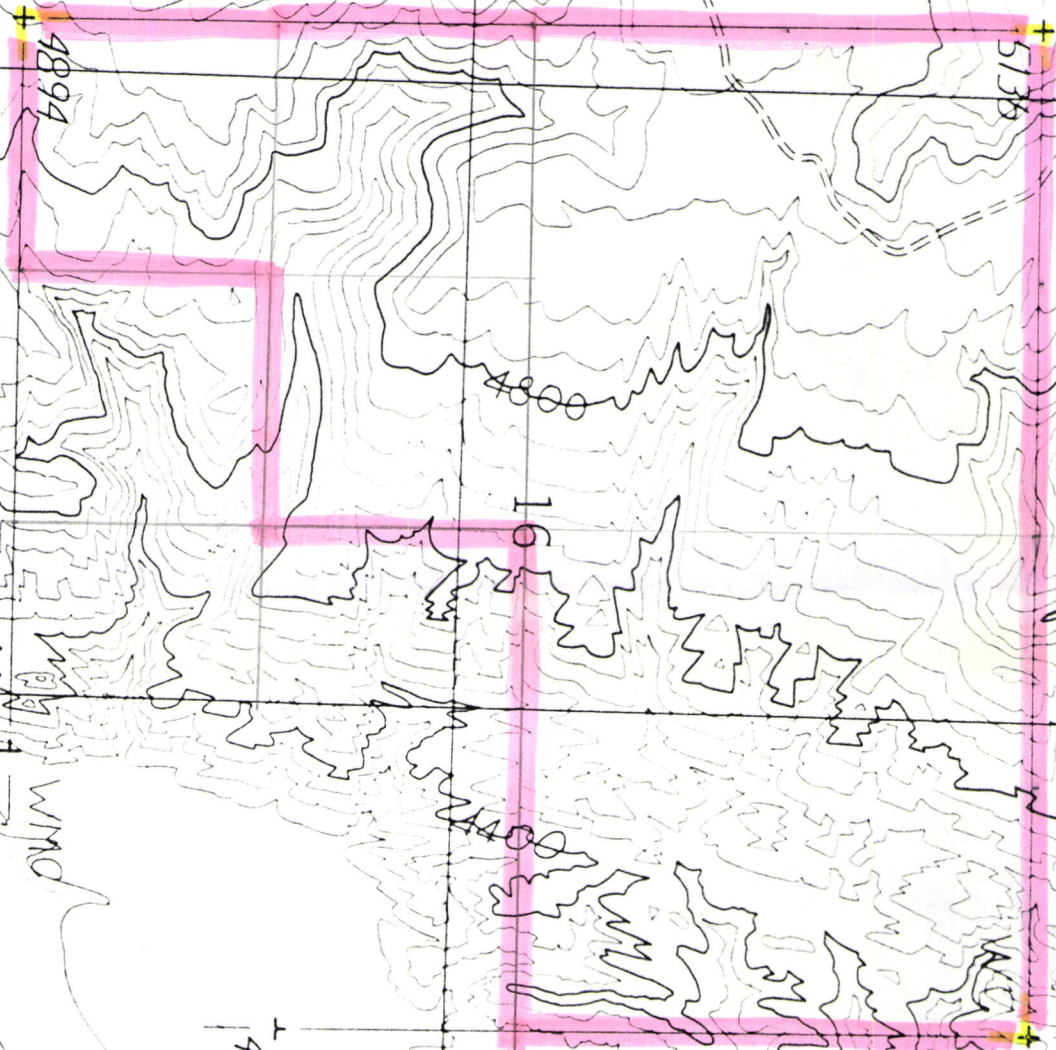

Four Foot Rapids

San

WMC  
4256

WMC  
4255

WMC

4908

16

4894

5136

5018

5000  
17

4600

4500

5000

5017

20

V 17

5180

5013

4400

5000

4443

4600

4800

21

4600

4400

